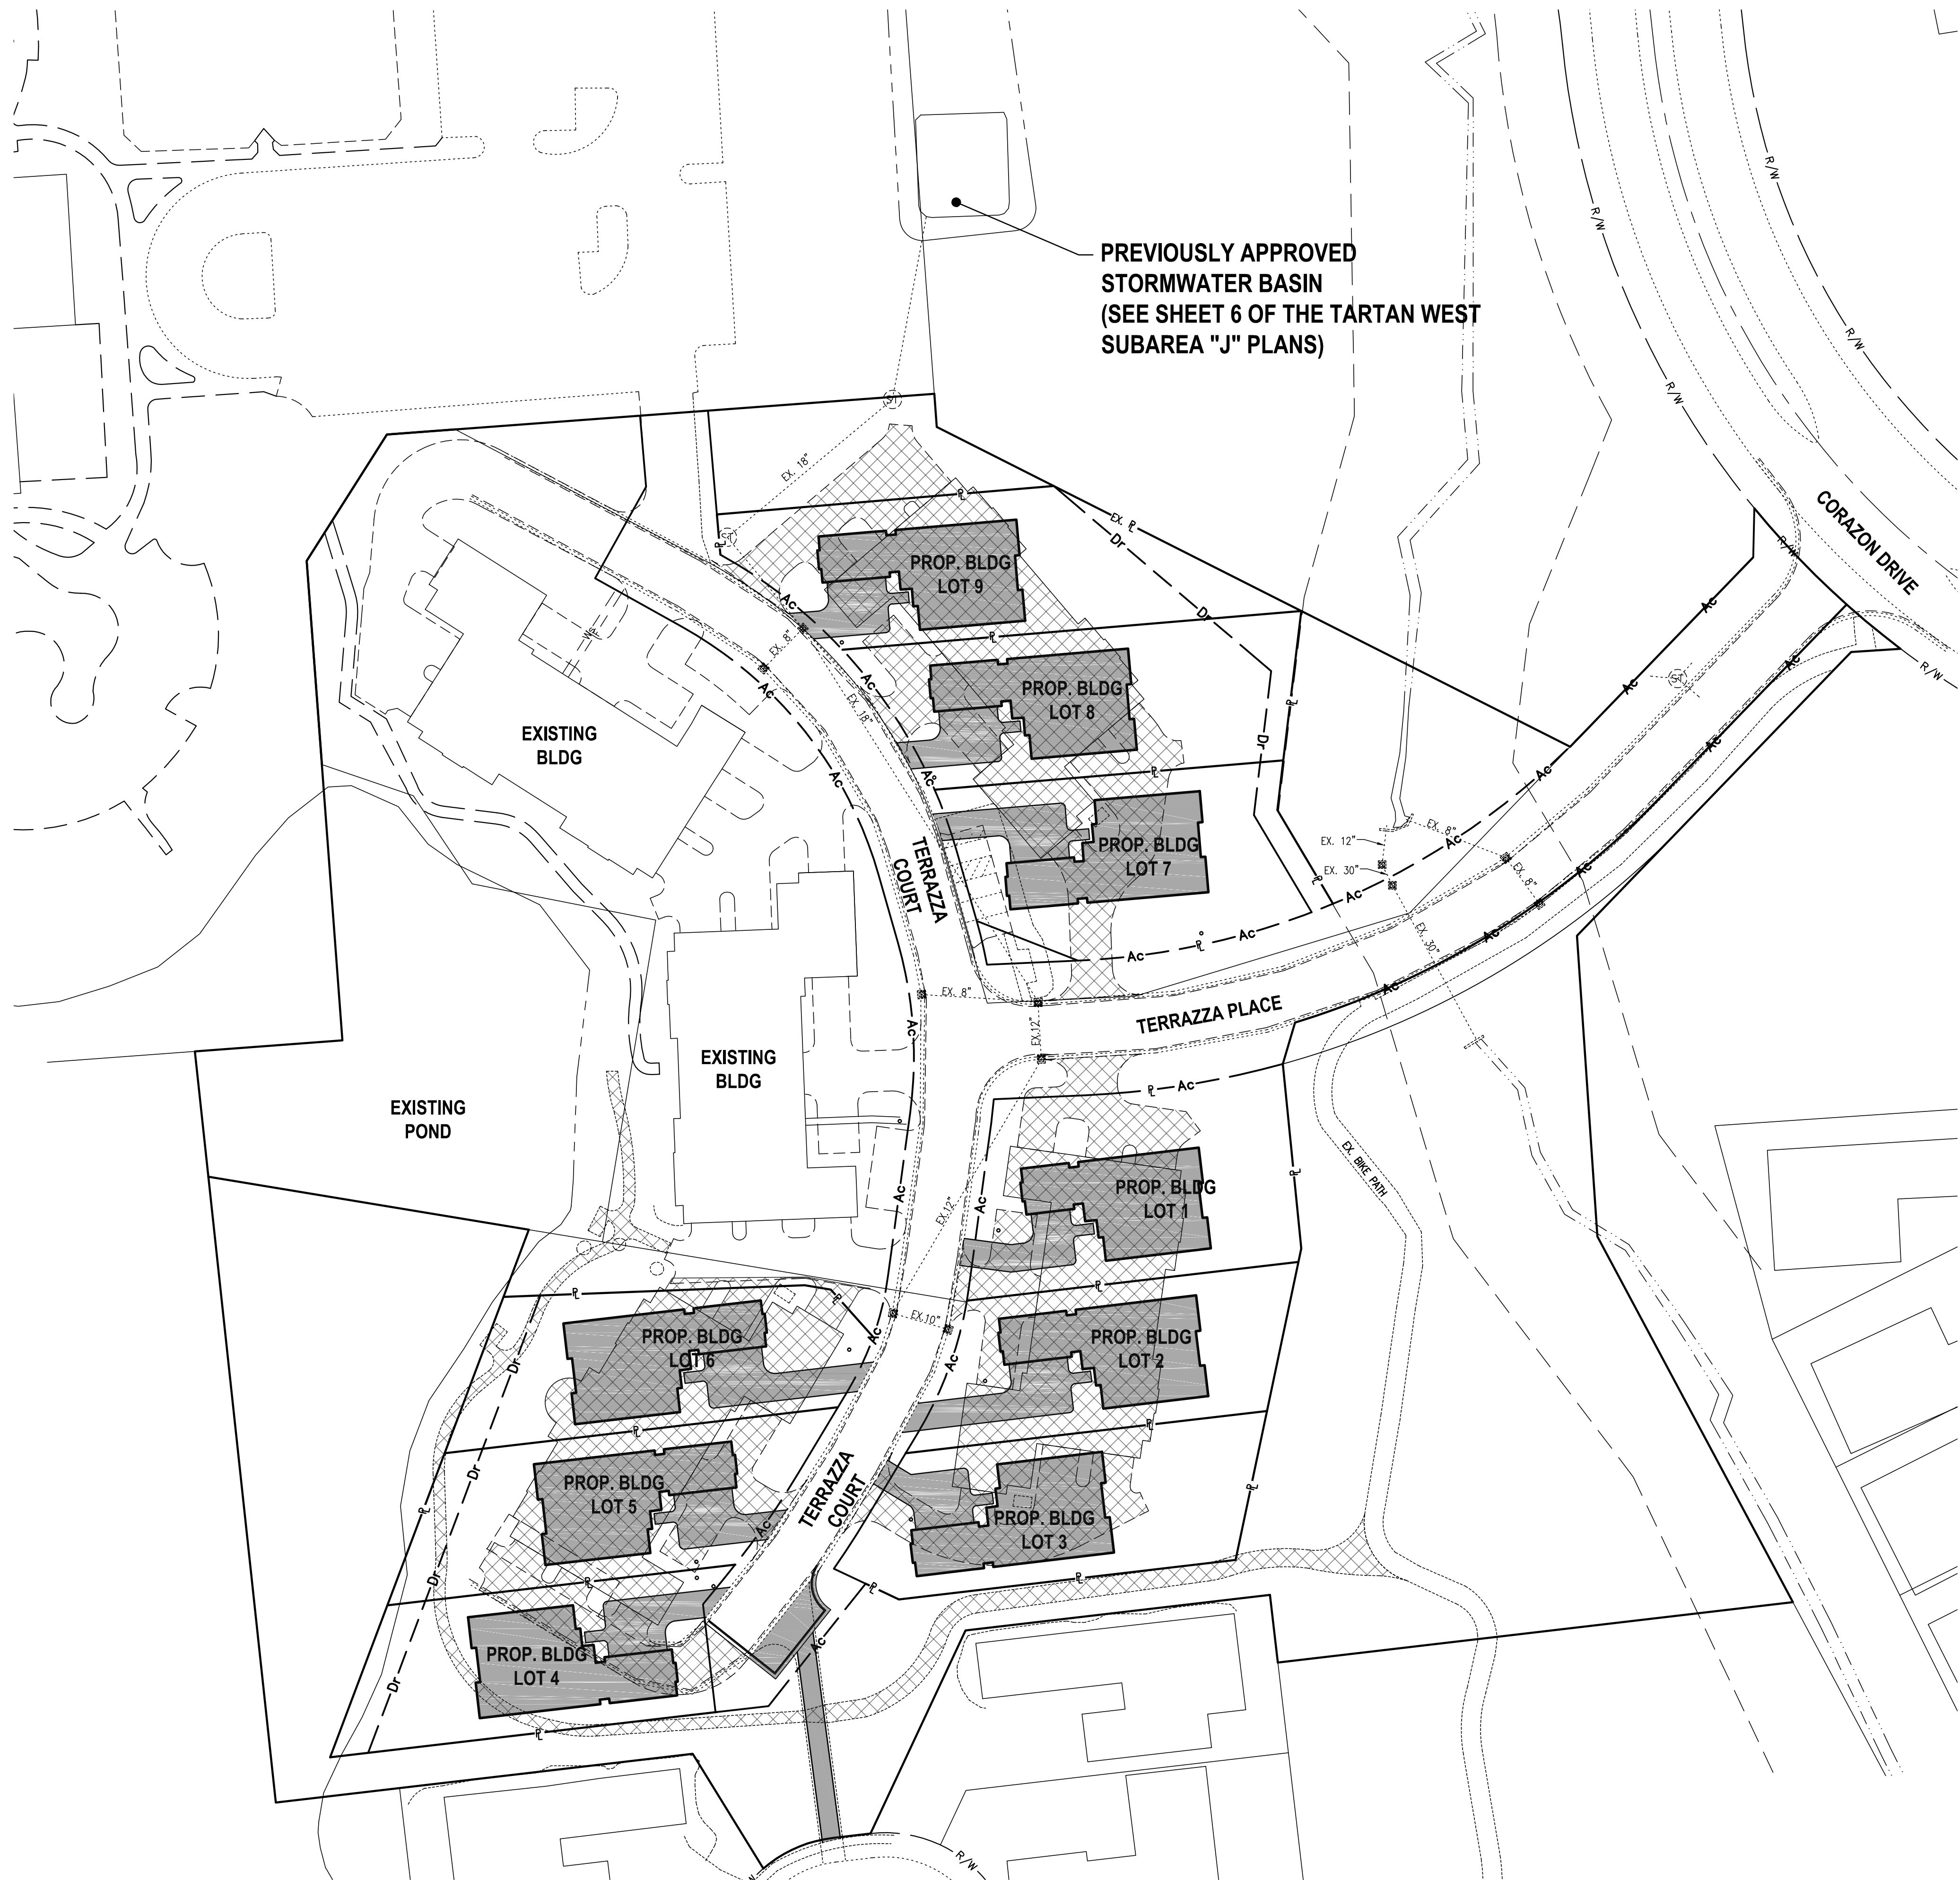

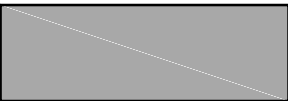



9/12/2016 9:01 AM I:\clients\active\sim\sim001\dwg\civil\sim001_post_vla.dwg abode



-  - PREVIOUSLY APPROVED IMPERVIOUS AREA NOT CONSTRUCTED
-  - PROPOSED IMPERVIOUS AREA WITH THIS PLAN

- TOTAL PREVIOUSLY APPROVED IMPERVIOUS AREA
2.90 ± AC
- PREVIOUSLY APPROVED IMPERVIOUS AREA NOT CONSTRUCTED
1.23 ± AC
- CURRENT CONDITIONS IMPERVIOUS AREA
1.68 ± AC
- TOTAL PROPOSED IMPERVIOUS AREA (INCLUDES EXISTING IMPERVIOUS AREA)
2.51 ± AC
- PROPOSED IMPERVIOUS AREA WITH THIS PLAN
0.83 ± AC

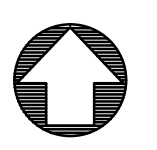
NOTE: AS BUILT PAVEMENT AND BUILDING AREAS SLIGHTY DIFFER FROM DESIGN LINEWORK. THE COMPARISON OF IMPERVIOUS ACREAGES FROM THE PREVIOUSLY APPROVED DESIGN TO THE CURRENT DESIGN MAY SHOW A 1% - 2% DISCREPANCY IN ACCURACY. OVERALL, THE CURRENT PROPOSED LAYOUT PROVIDES A DECREASE IN IMPERVIOUS AREA AS COMPARED TO THE DESIGN CRITERIA FOR THE STORM WATER BASIN.



HORIZONTAL SCALE
IN FEET

DRAWN	SCE	CHECKED	JL	DATE
				8-11-2016

PLAN	ISSUE/REVISION	NO.


59 Grant Street
Newark, Ohio 43055
PH: (740) 344-5451
www.jobshenderson.com
A HULL COMPANY

SITE CONSTRUCTION PLAN FOR:
TARTAN WEST
POST TRIBUTARY EXHIBIT

JOB NUMBER:
SIM001

1